


UNIT G 5.1

UNIT G 5.2

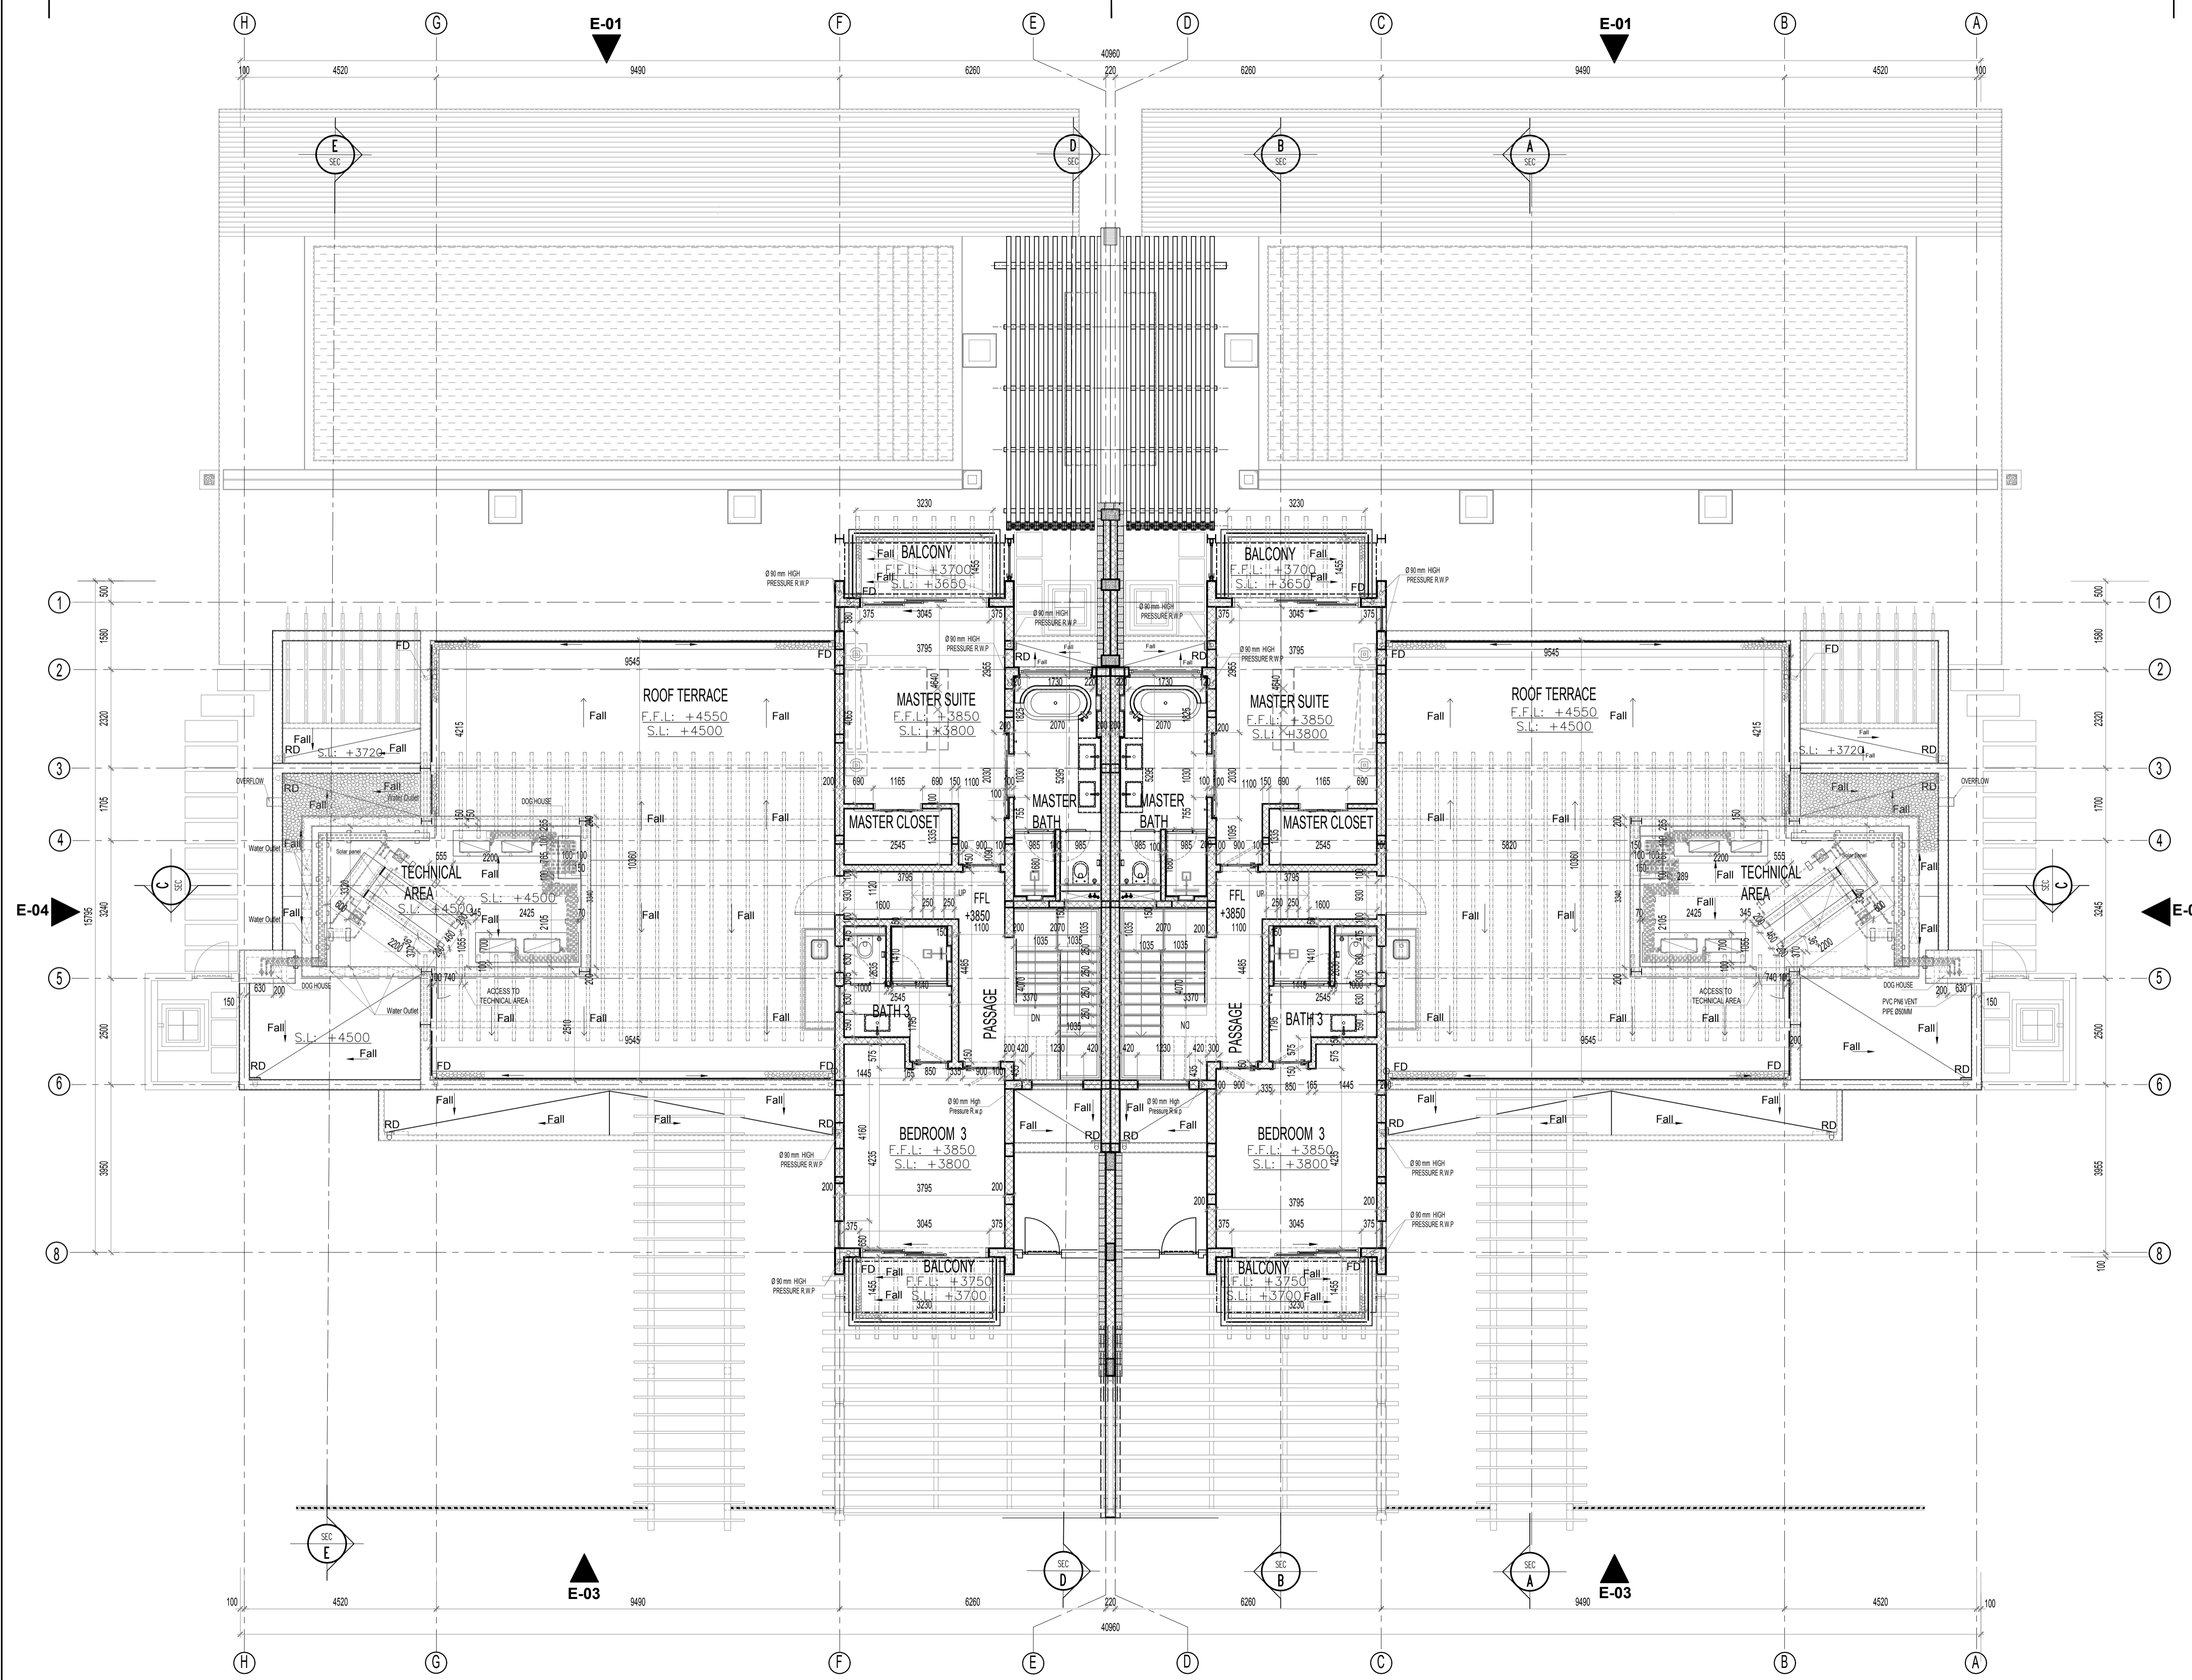

job no.	consult.	stage	location	sheet no.	rev.
DV-17	A1	ASB	G5	201	AS

revisions	date	rev.	ini.
AS. ISSUE FOR AS-BUILT.	15.08.19	AS	S.D

- GENERAL NOTES**
- DO NOT SCALE FROM THIS DRAWING. USE FIGURED DIMENSIONS ONLY.
 - ALL LEVELS & DIMENSIONS TO BE CHECKED ON SITE BEFORE WORK COMMENCES.
 - THE ARCHITECT SHALL NOT BE HELD RESPONSIBLE FOR DIMENSIONAL ERRORS IF NOT NOTIFIED AT THE TIME OF COMMENCING WORK ON SITE.
 - CUTTING & FILLING TO BE DETERMINED ON SITE WHEN COMMENCING WORK.
 - DIMENSIONS ARE GIVEN IN MILLIMETRES UNLESS OTHERWISE STATED.

ARUP
 Arup SIGMA
 Bagatelle Office Park
 Bagatelle Mauritius
 Tel +230 601 9800 Fax +230 468 8338
 www.arup.com

Daniel Wong Chung Co. Ltd.
 Consulting Engineers
 5, Sir Charles Lees Street Curepipe
 Tel 674-5727, Fax 670-0249
 VAT No. VAT20131934

- MACBETH ARCHITECTS & DESIGNERS LTD Architect and Designers
- 2/F Light House, Vivida Business Park, Saint Pierre 61430, Mauritius
- T + (230) 433 8876 F + (230) 433 8883
- E. Administration < Secretary@macbeth.mu >
- E. Drawing office
- VAT No. 27432993



THIS DRAWING IS COPYRIGHT

RESIDENTIAL DEVELOPMENT

client: **ANAHITA ESTATES LTD**

site: **PARCEL G ANAHITA MAURITIUS**

drawing title: **ANAHITA VILLAS PLOT G5 - DUPLEX VILLAS FIRST FLOOR PLAN**

scale	date started	drawn by
1:75	03.05.17	S.D

job no.	consult.	stage	location	sheet no.	rev.
DV-17	A1	ASB	G5	201	AS