

[illegible]

Swan Lake - Tyee Lake Intertie
138kV Intertie
Plan & Profile - Structures #189 to #196

T02-D-55-0138-R01

36 of 53

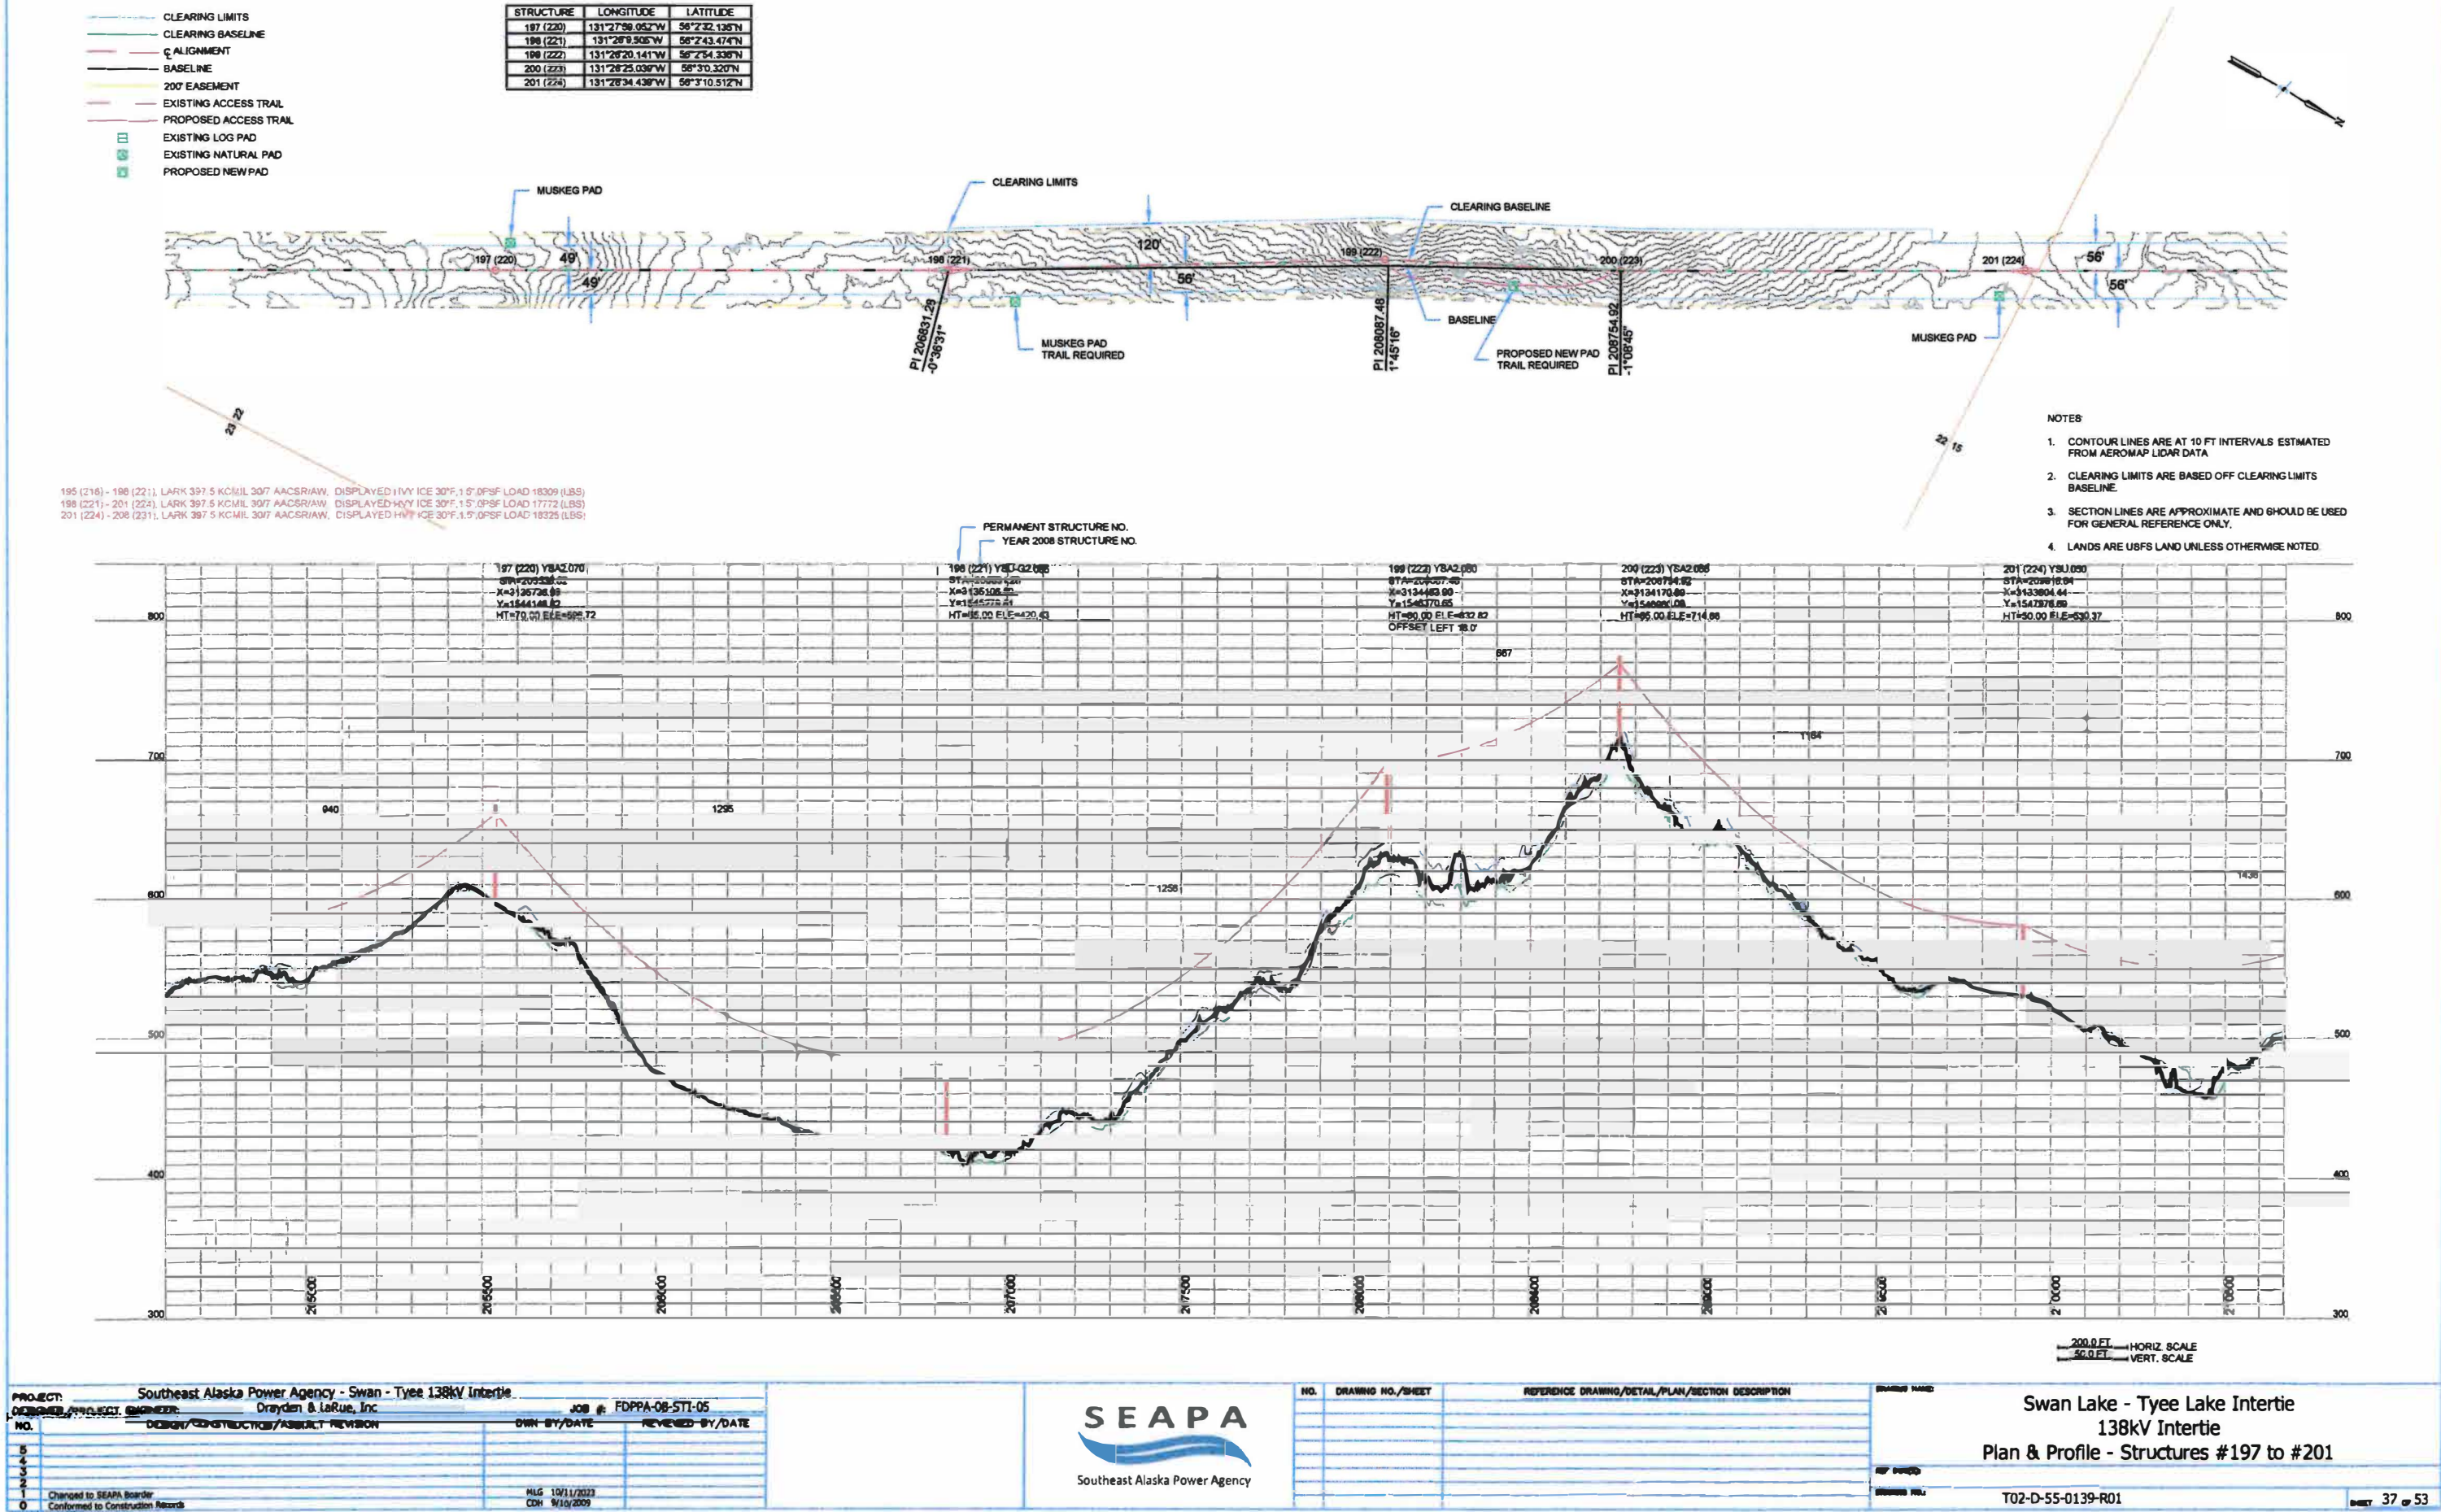

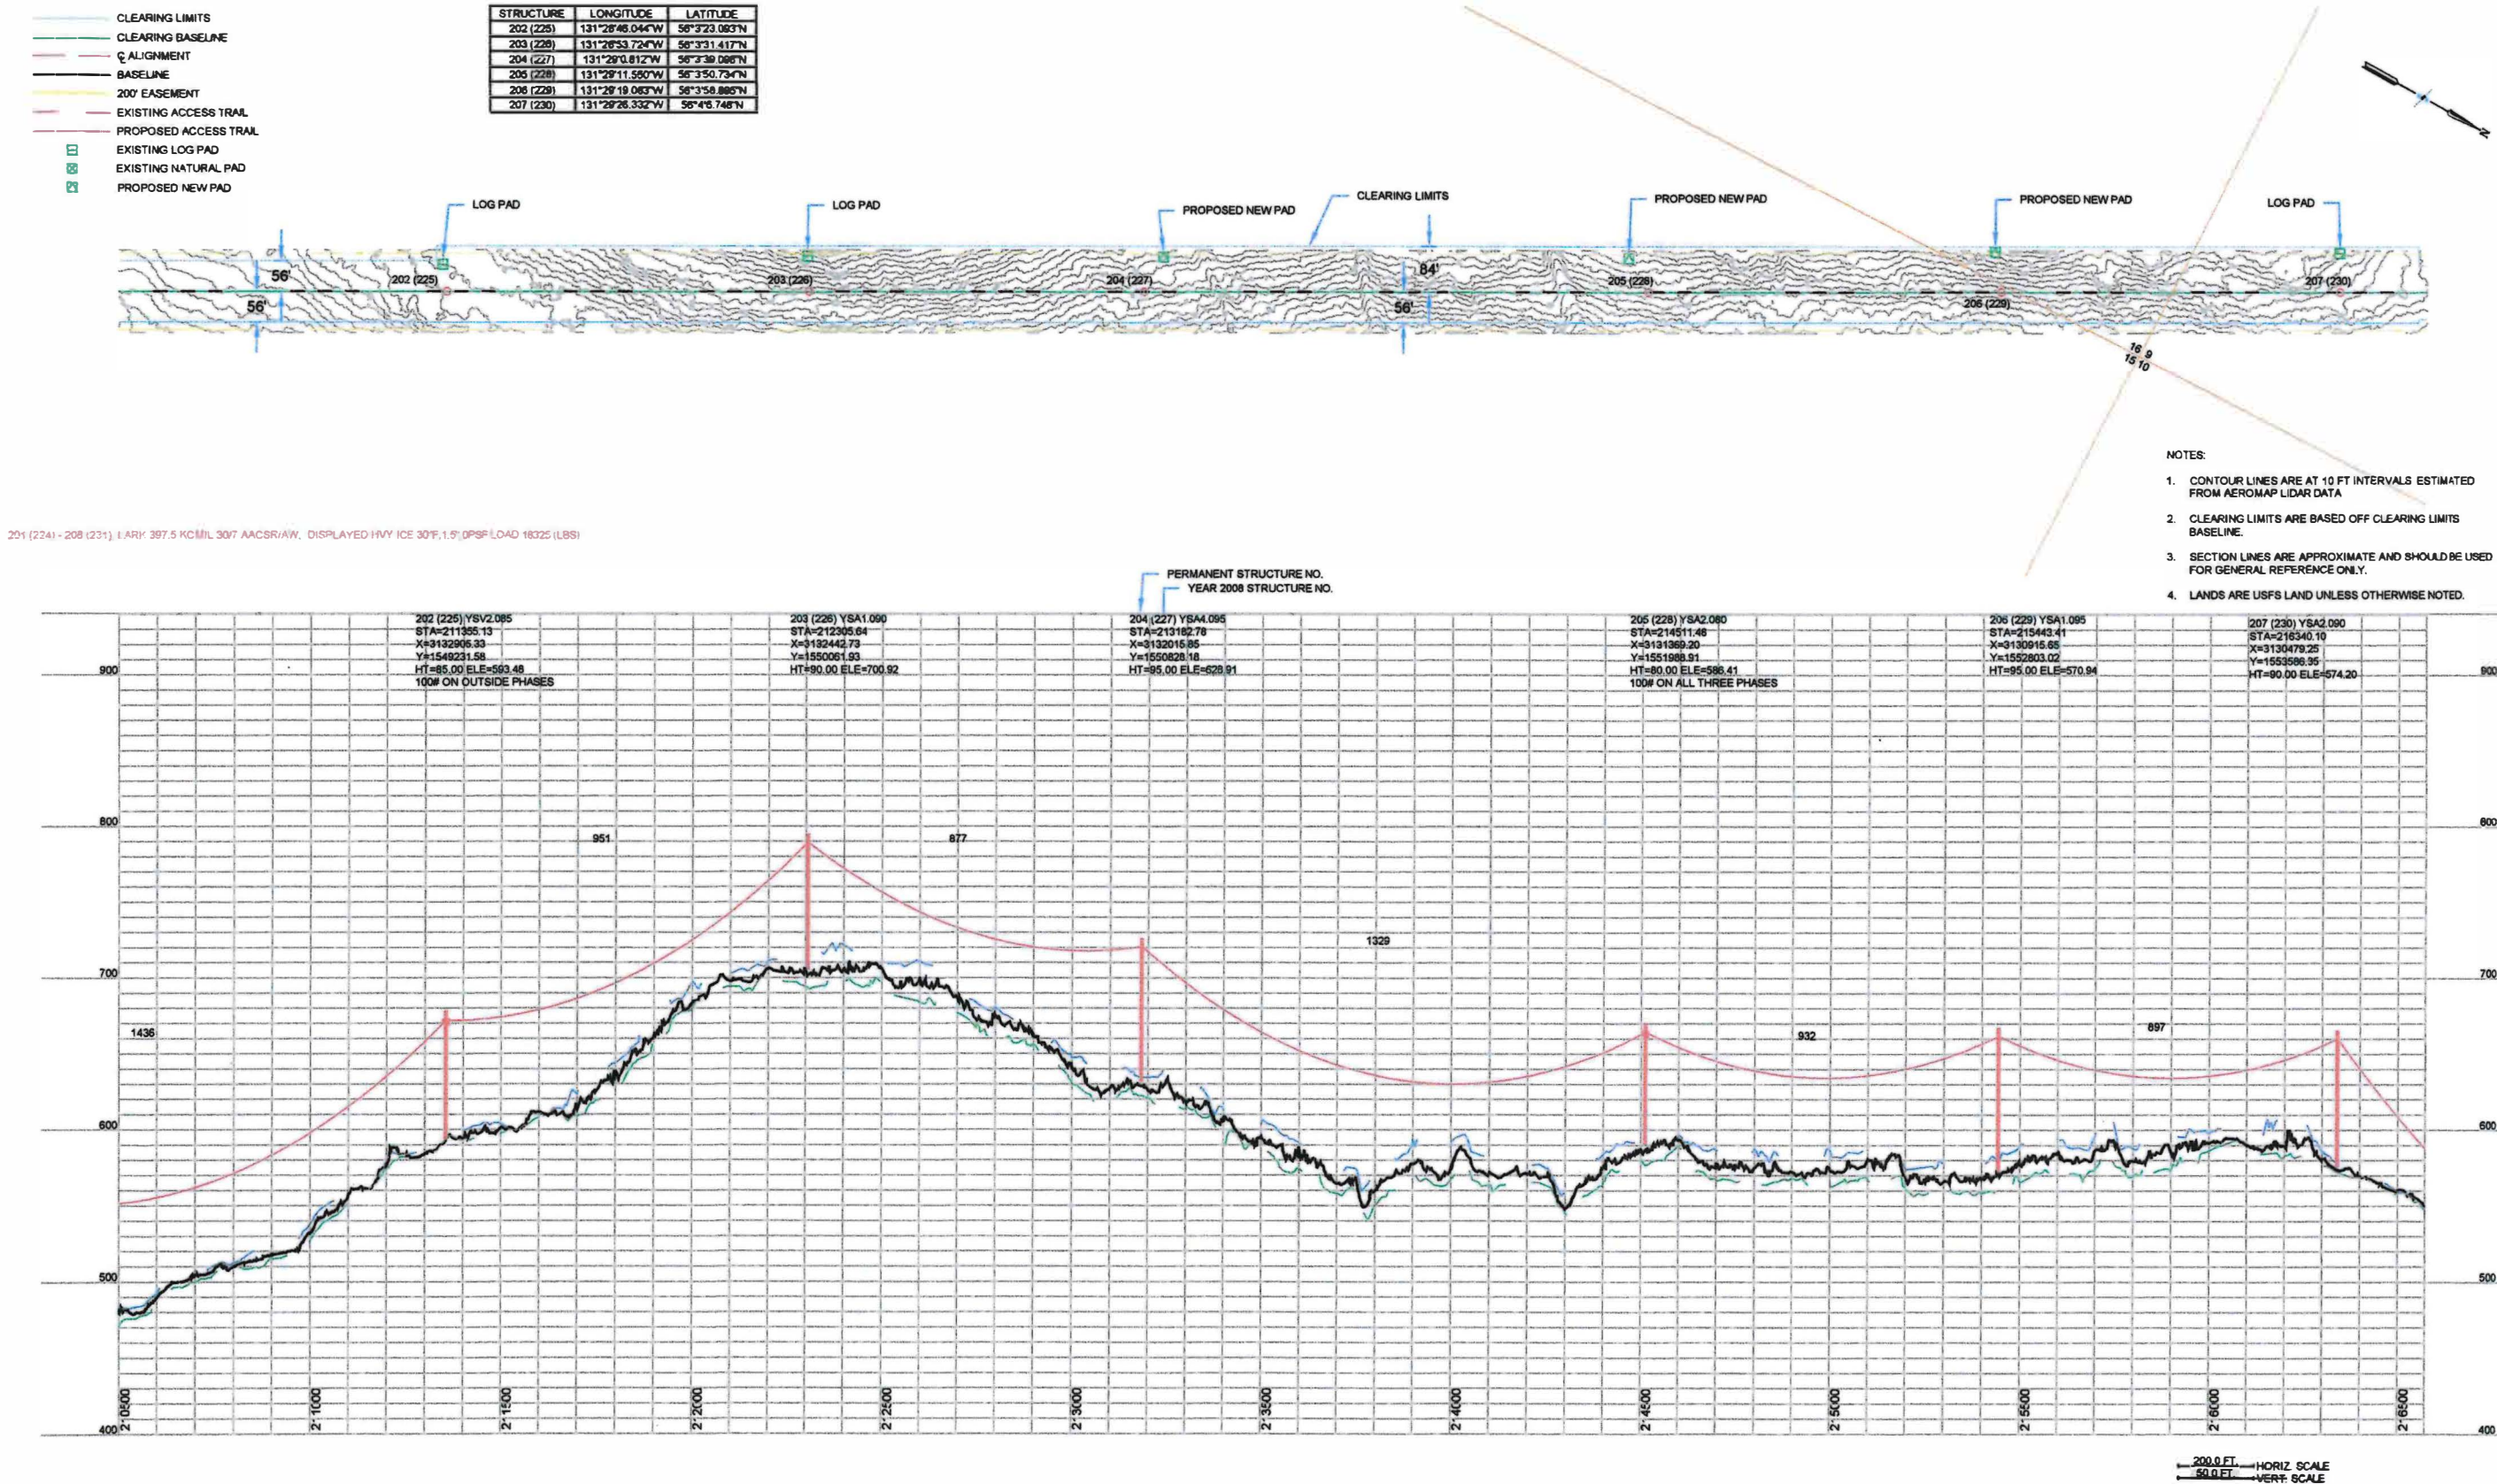


PROJECT: Southeast Alaska Power Agency - Swan - Tye 138kV Intertie		
DESIGNER/PROJECT ENGINEER: Drayden & LaRue, Inc		
JOB #: FDPPA-08-STI-05		
NO.	DESIGN/CONSTRUCTION/ASBULT REVISION	REVIEWED BY/DATE
5		
4		
3		
2		
1	Changed to SEAPA Boarder	HLG 10/11/2023
0	Confirmed to Construction Records	CDH 9/10/2009



NO.	DRAWING NO./SHEET	REFERENCE DRAWING/DETAIL/PLAN/SECTION DESCRIPTION

Swan Lake - Tye Lake Intertie 138kV Intertie Plan & Profile - Structures #202 to #207	
REF DWG(S):	
DRAWING NO.:	T02-D-55-0140-R01
SHEET	38 of 53

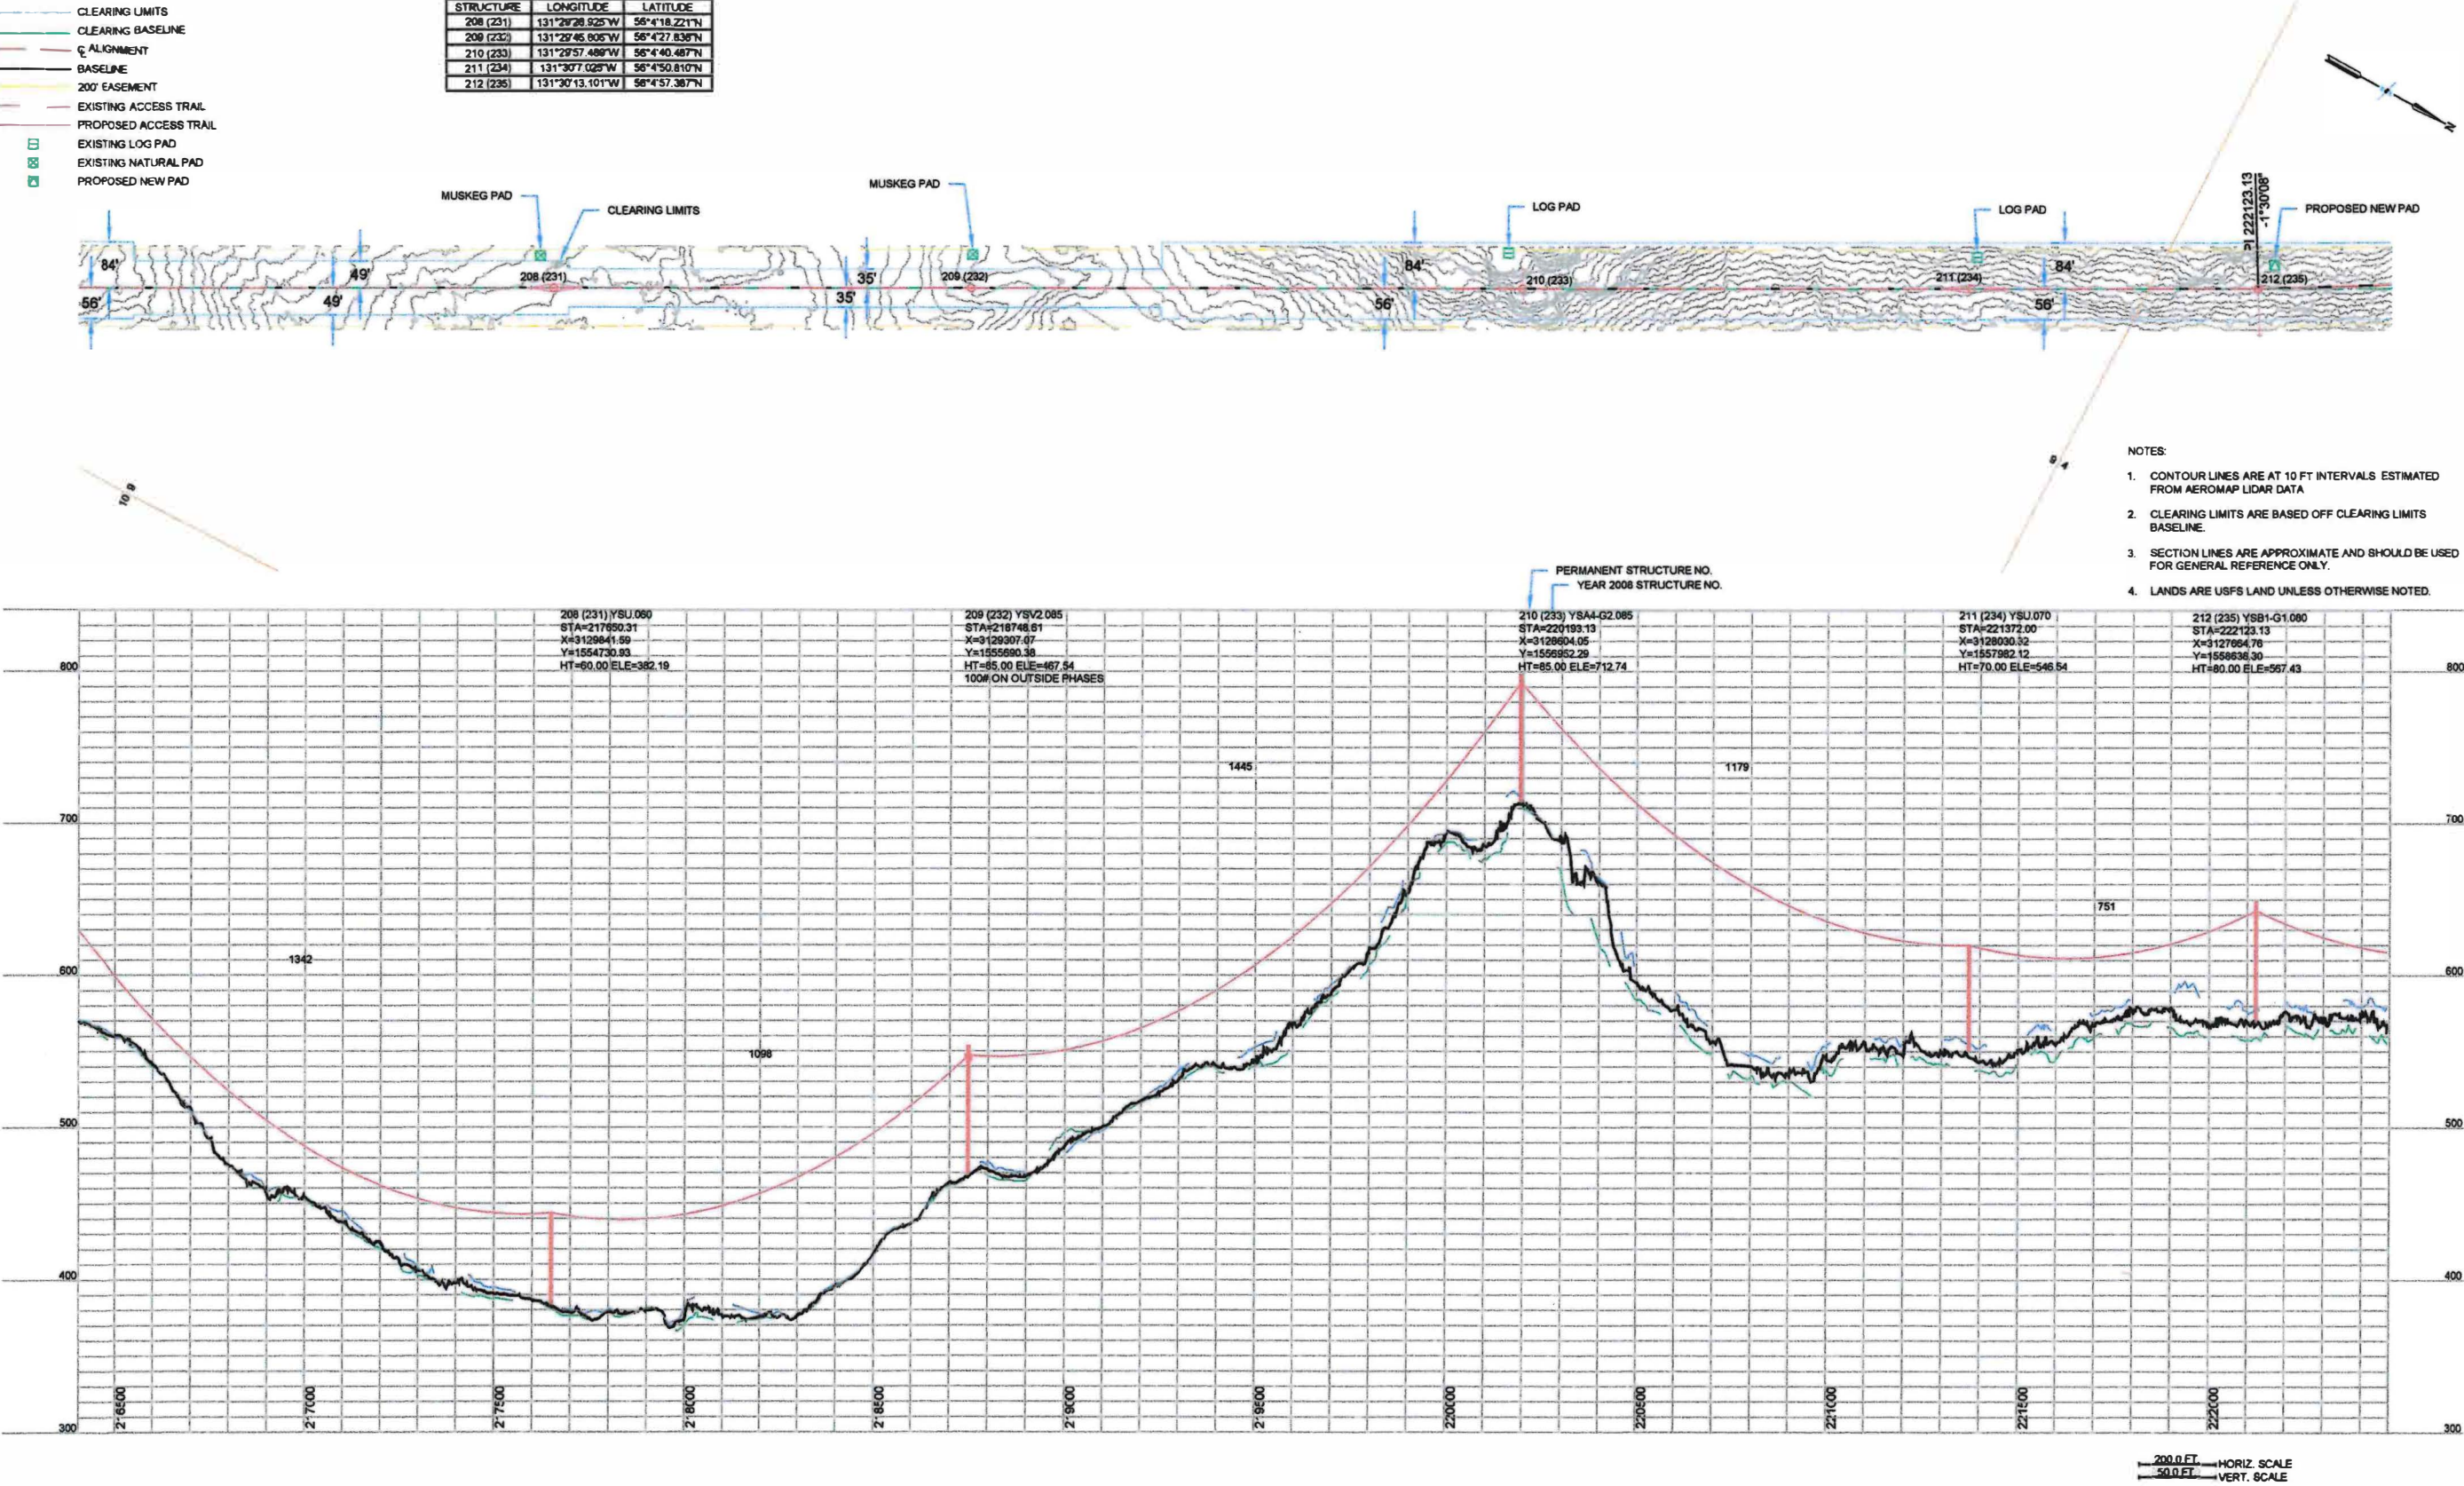



PROJECT: Southeast Alaska Power Agency - Swan - Type 138kV Intertie			
DESIGNER/PROJECT ENGINEER: Drayden & LaRue, Inc			
JOB #: FDPPA-06-STI-05			
NO.	DESIGN/CONSTRUCTION/ASSEMBLY REVISION	DWN BY/DATE	REVIEWED BY/DATE
5			
4			
3			
2			
1	Changed to SEAPA Boarder	HLG 10/11/2023	
0	Conformed to Construction Records	CDH 9/19/2009	



NO.	DRAWING NO./SHEET	REFERENCE DRAWING/DETAIL/PLAN/SECTION DESCRIPTION

SWAN LAKE	Swan Lake - Tye Lake Intertie
138kV Intertie	138kV Intertie
Plan & Profile - Structures #208 to #212	Plan & Profile - Structures #208 to #212
DESIGNED BY:	
DRAWN BY:	
CHECKED BY:	
DATE:	
PROJECT NO.:	T02-D-55-0141-R01
SHEET	39 of 53

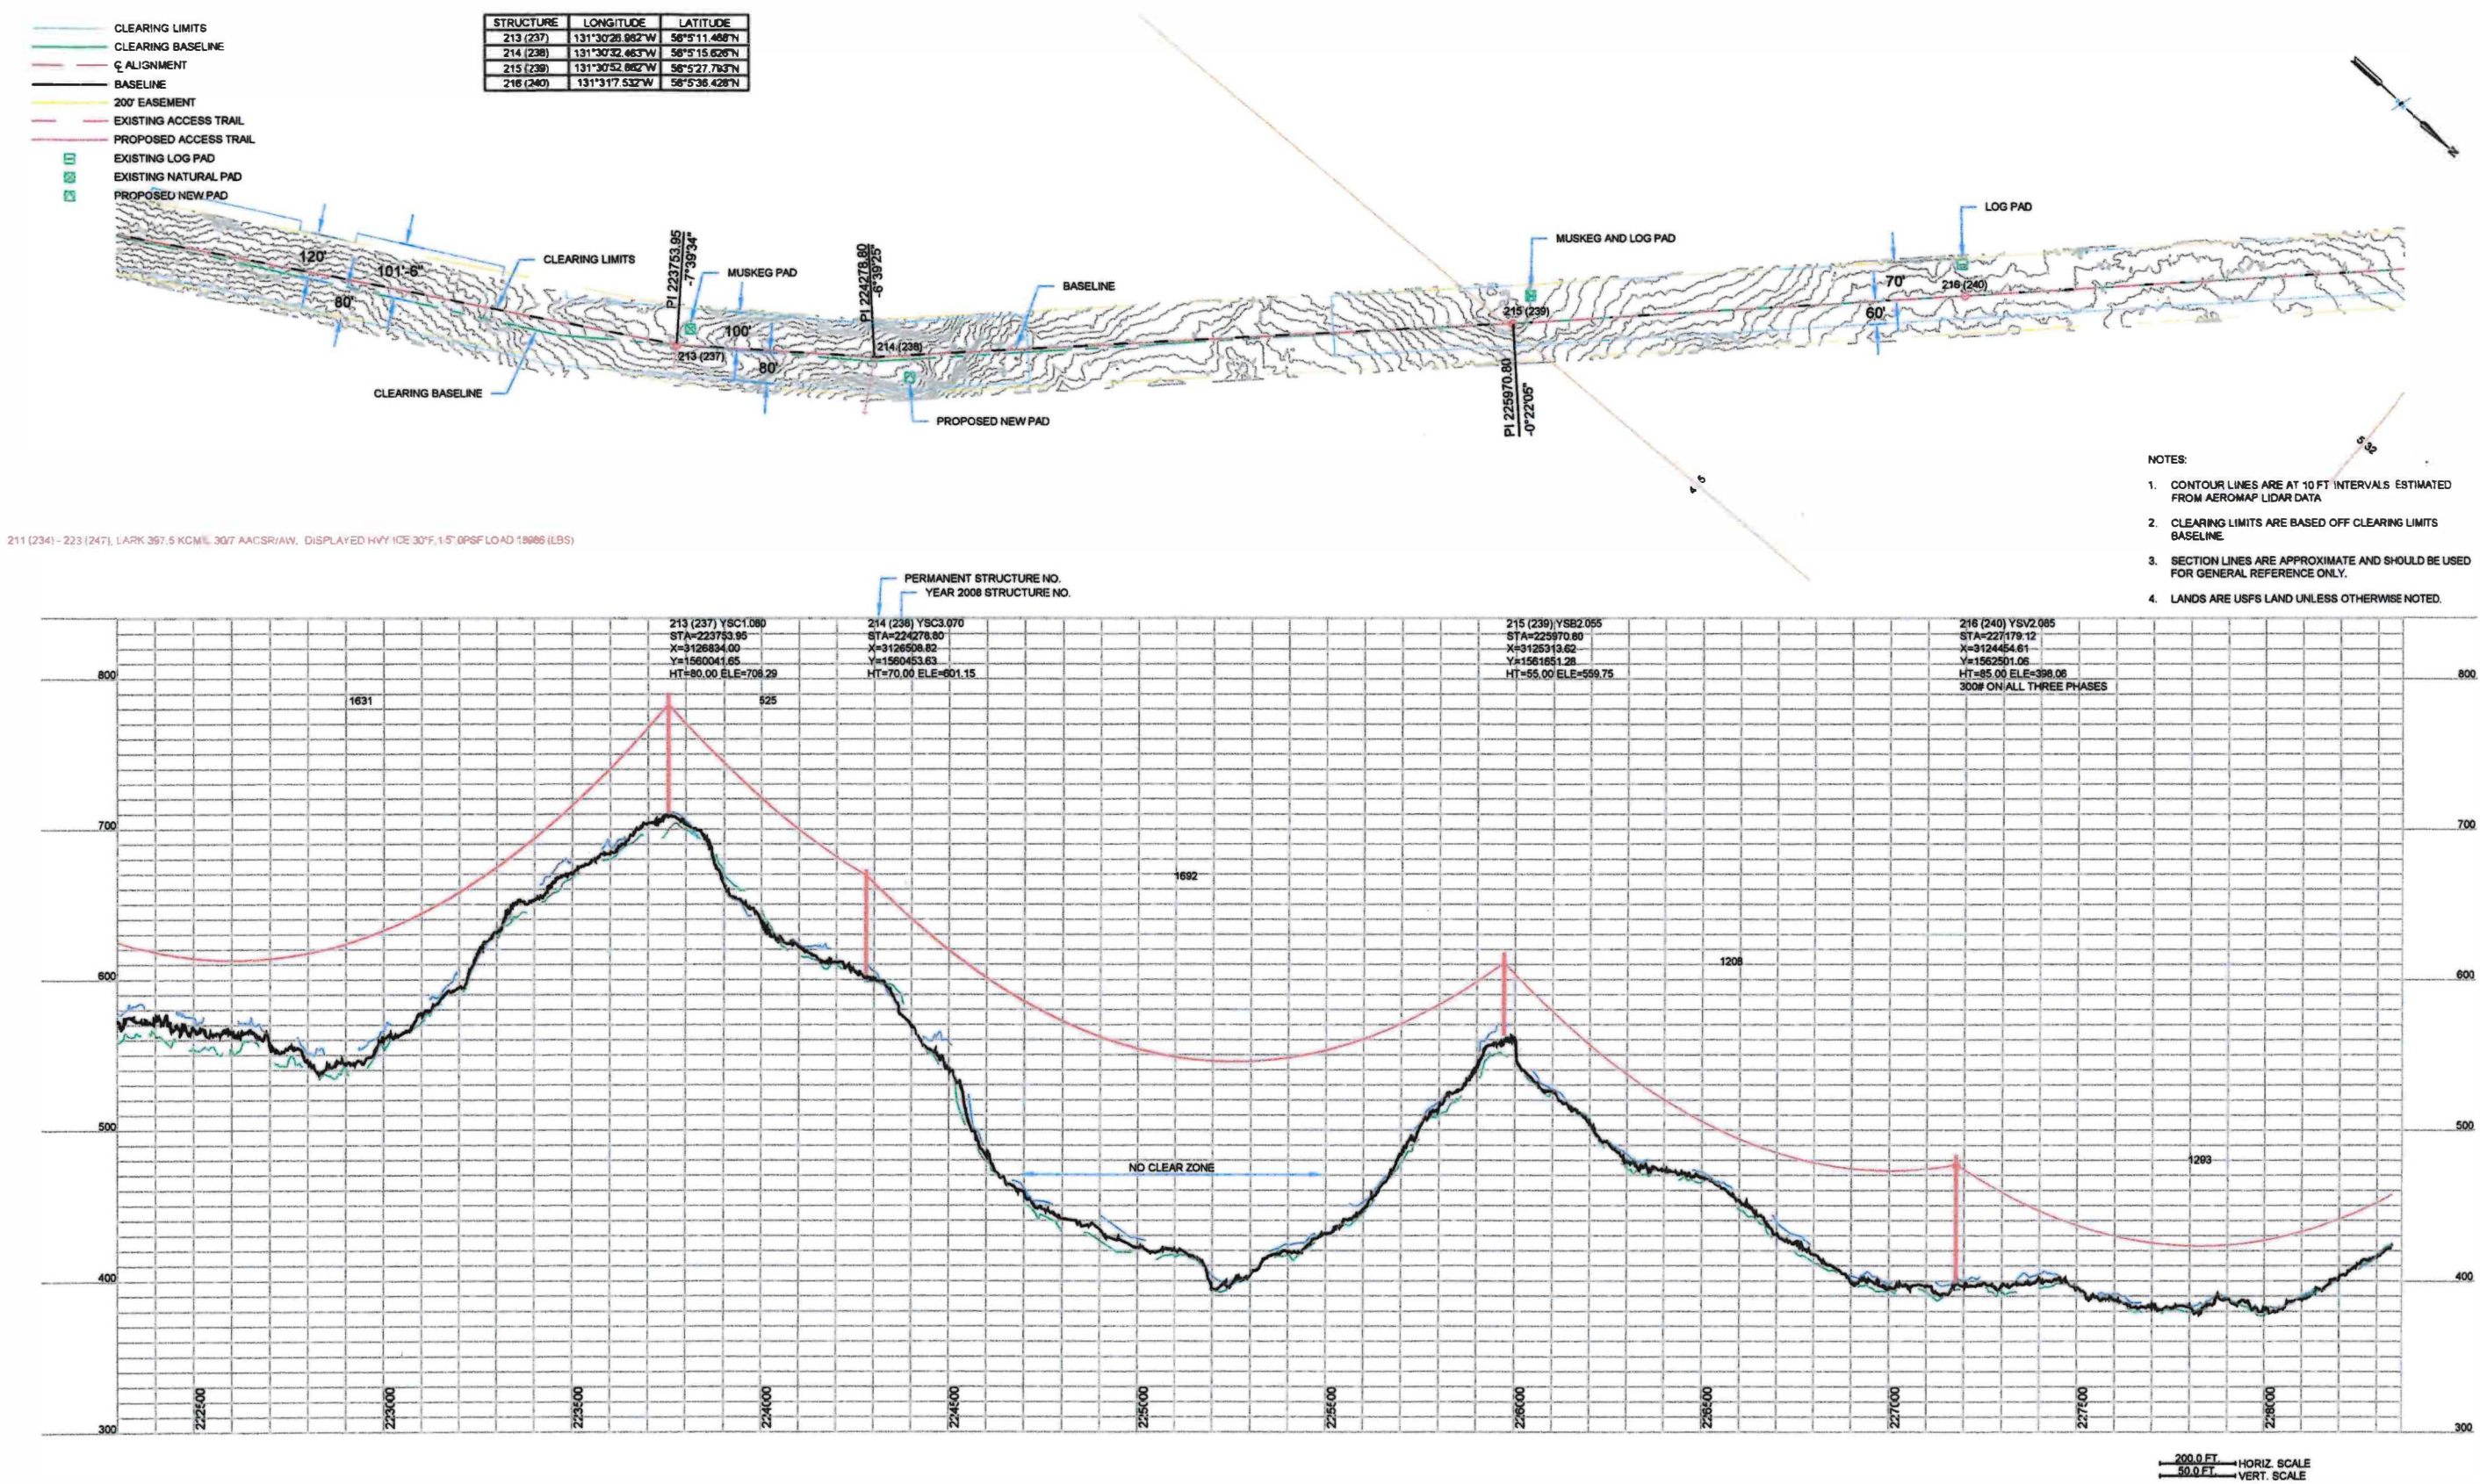

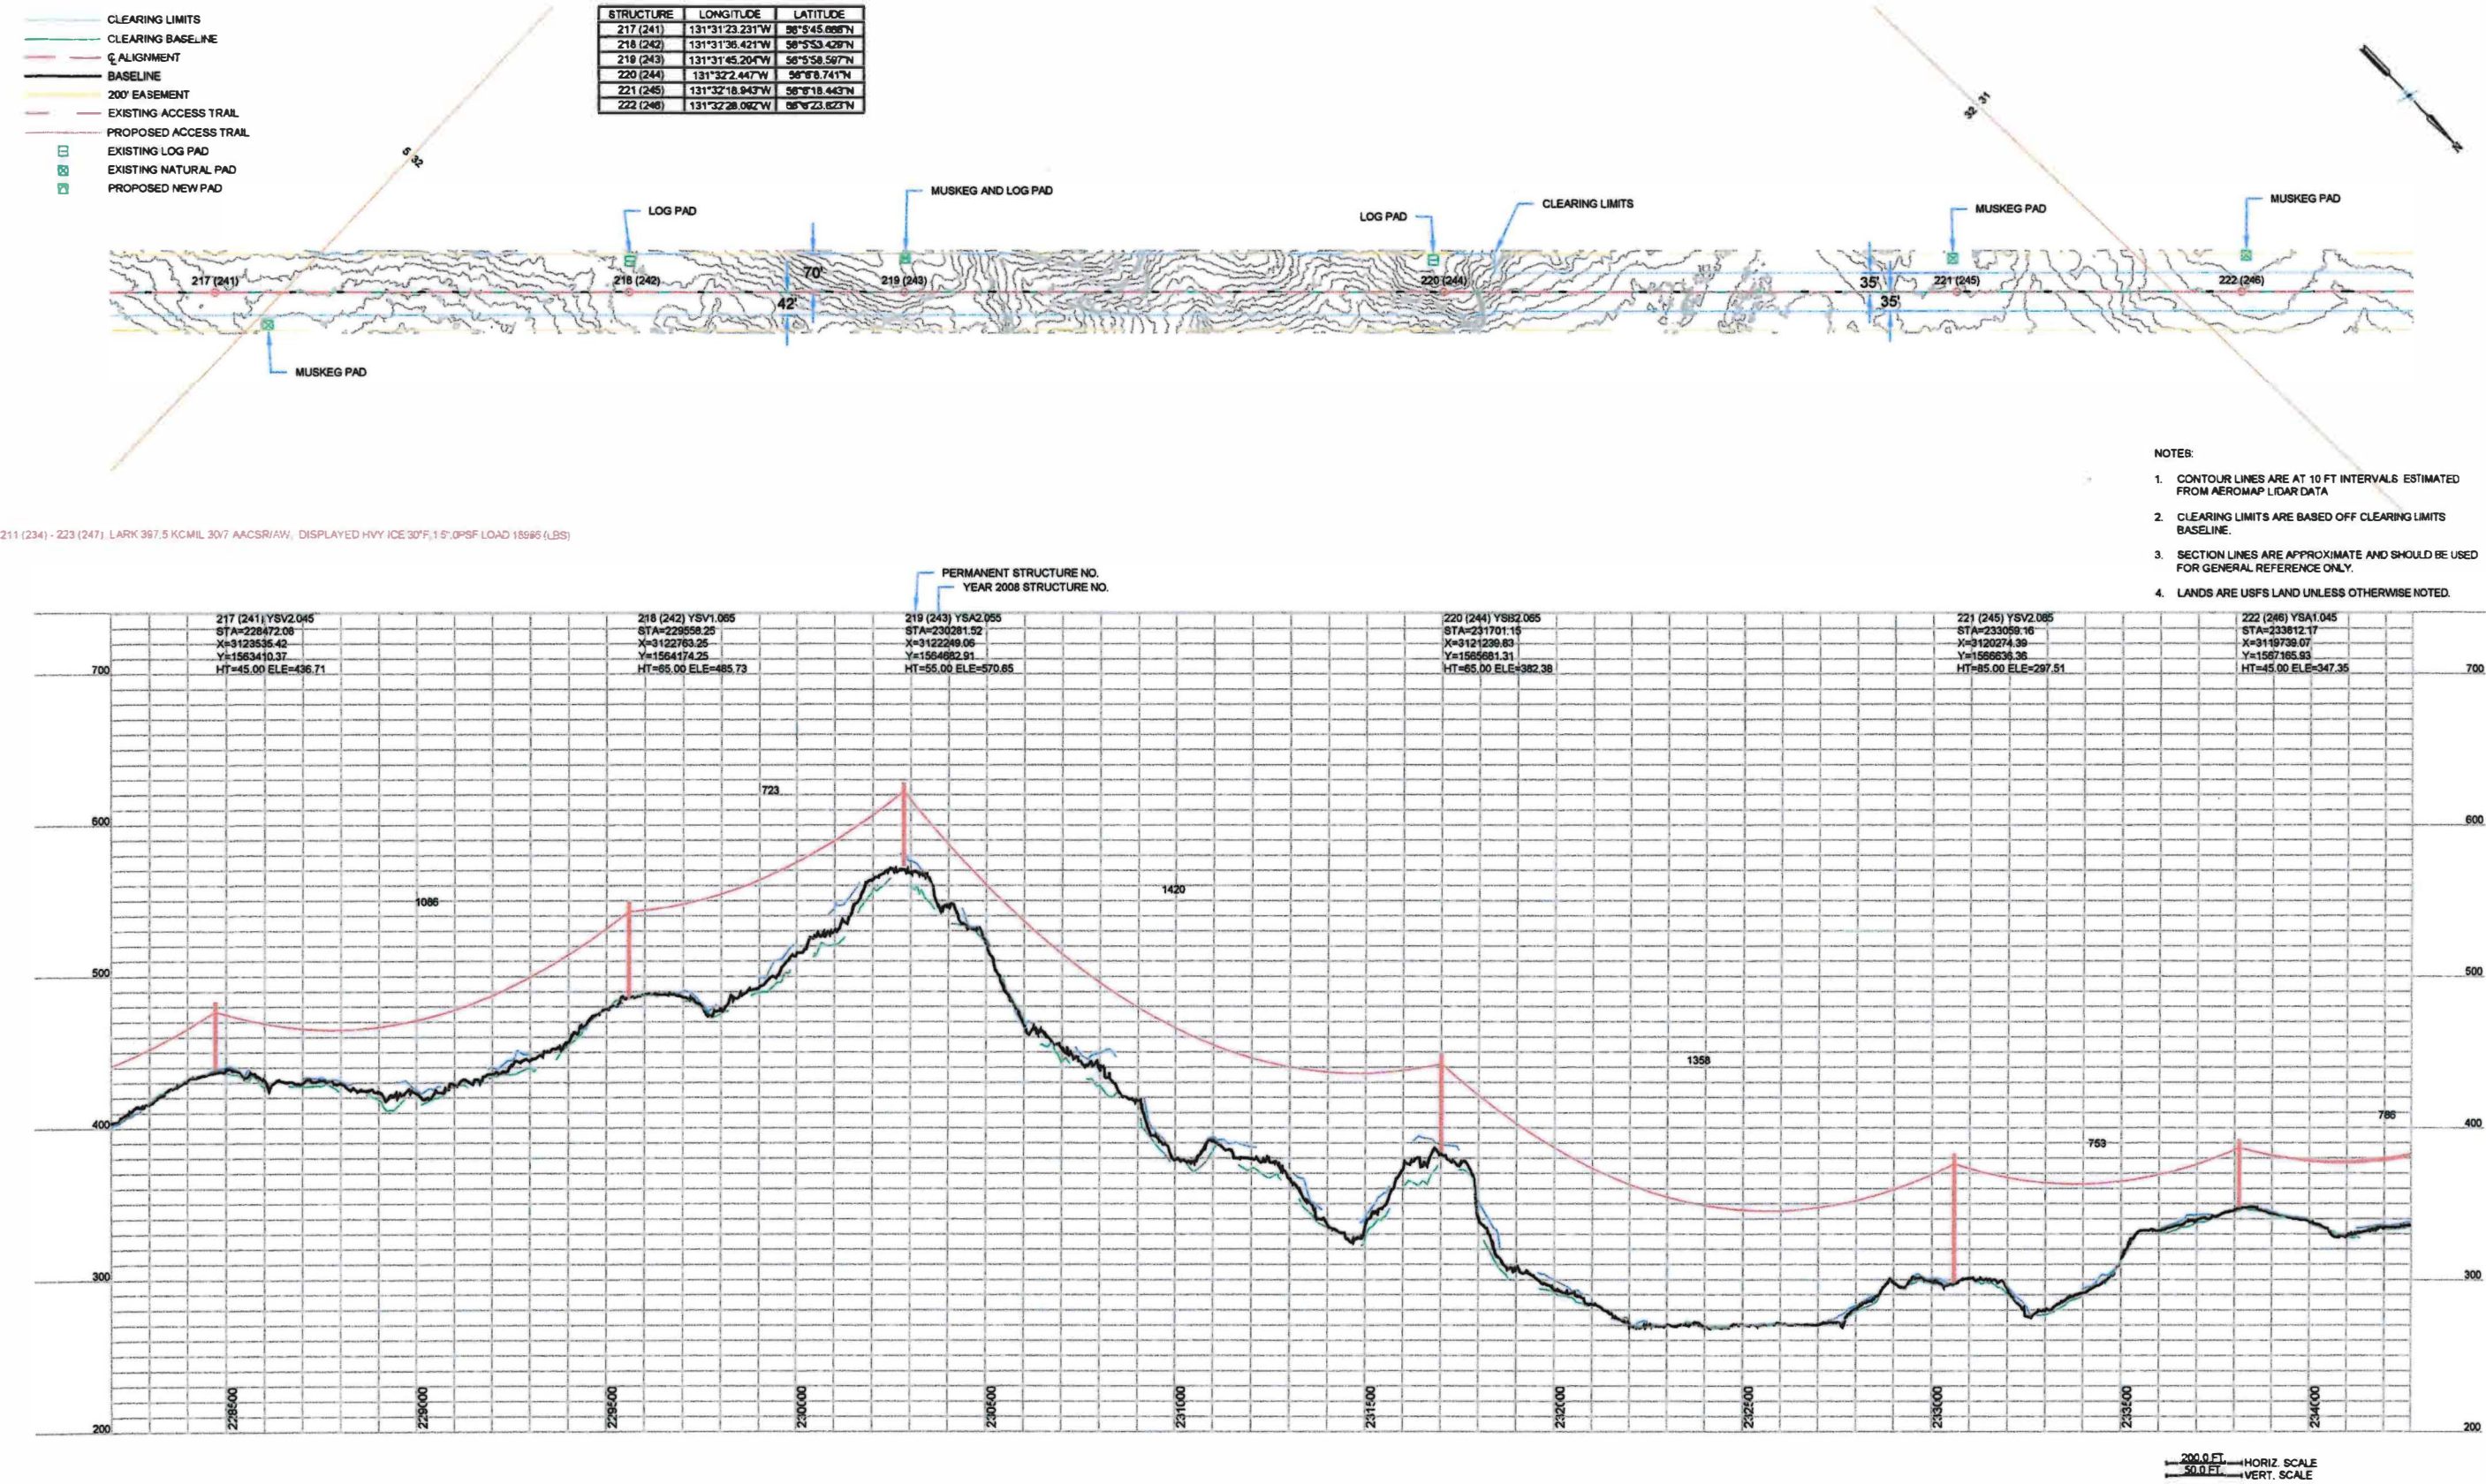

PROJECT: Southeast Alaska Power Agency - Swan - Tyee 138kV Intertie	
DESIGNER/PROJECT ENGINEER: Dryden & LaRue, Inc.	JOB # FDPPA-08-STI-05
NO.	DESIGN/CONSTRUCTION/ASSEMBLY REVISION
5	
4	
3	
2	
1	Changed to SEAPA Boarder
0	Conformed to Construction Records
DWN BY/DATE	REVIEWED BY/DATE
HUG 10/11/2023	
CDH 9/10/2025	



NO.	DRAWING NO./SHEET	REFERENCE DRAWING/DETAIL/PLAN/SECTION DESCRIPTION

SWAN LAKE	Swan Lake - Tyee Lake Intertie
REF. DRAWING	138kV Intertie
SWAN LAKE	Plan & Profile - Structures #217 to #222
	T02-D-55-0143-R01
	41 53