


Exhibit D to RFP Re Replacement of Two Wooden Transmission Towers / Page 1 of 1 page.



| PROJECT: <u>Southeast Alaska Power Agency - Swan Lake 115kV Transmission Line</u> | | | |
|-----------------------------------------------------------------------------------|-----------------------------------------|-------------|----------|
| DESIGNER/PROJECT ENGINEER: <u>R.W.Bekk and Associates</u> | | JOB #: | |
| NO. | DESIGN/CONSTRUCTION/ASBUILT REVISION | DWY BY/DATE | REVIEWED |
| 5 | | | |
| 4 | | | |
| 3 | | | |
| 2 | | | |
| 1 | Changed to SEAPA boarder | MLH | 11/18/20 |
| 0 | R49 - Conformed to Construction Records | EM | 1/10/85 |
| | | | DKS |

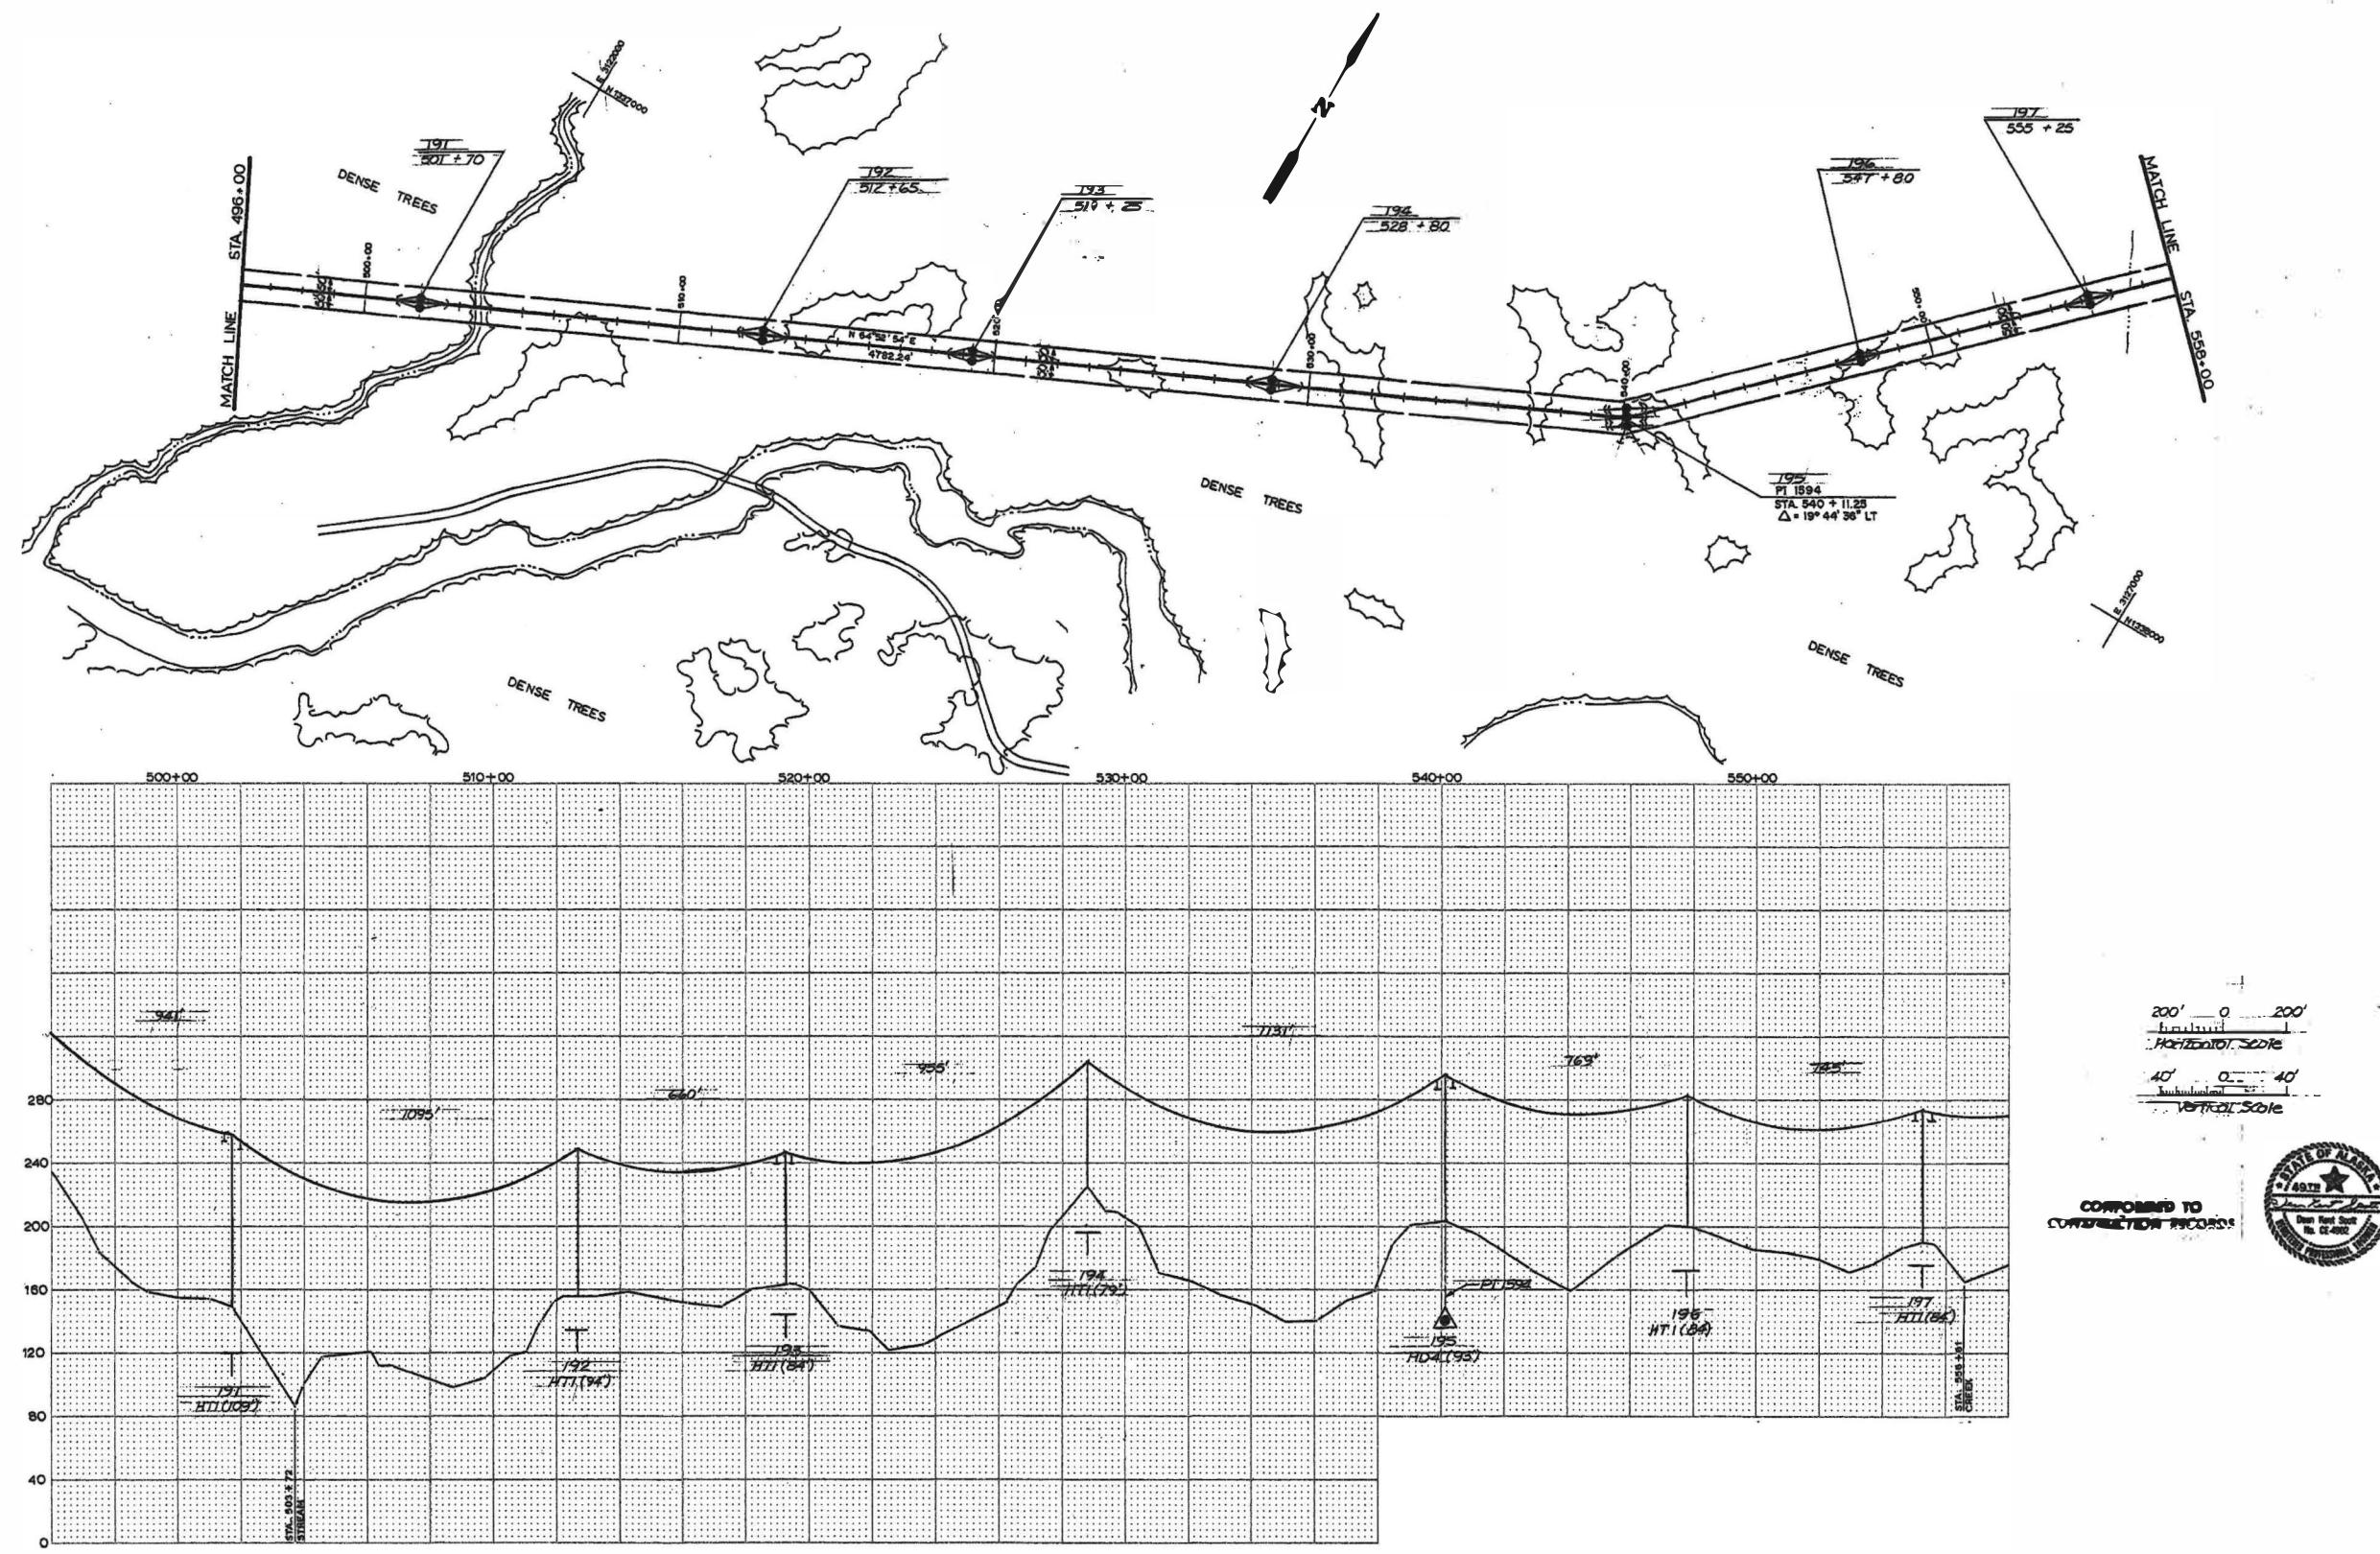

| NO. | DRAWING NO./SHEET | REFERENCE DRAWING/DETAIL/PLAN/SECTION DESCRIPTION | DRAWING NAME | Swan Lake Hydroelectric Project |
|-----|-------------------|---------------------------------------------------|--------------|----------------------------------------|
| | | | | 115kV Transmission Line |
| | | | | Cross-Country Portion - Plan/Profile 9 |
| | | | REF. ORDER# | 674-58-218.3 |
| | | | DRAWING NO. | H03-D-55-0019-R01 |
| | | | SHEET | OF |